


1 SUITE 115 FLOOR PLAN
SCALE: 1/8" = 1'-0"

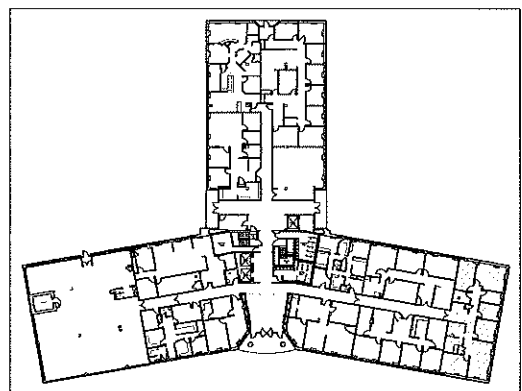

A FIRST FLOOR SUITE LOCATION PLAN
SCALE: 1/8" = 1'-0"

GC GRAMMAS CONSULTANTS 208 ROUTE 104, SUITE 208, FARMINGDALE, NY 11735 TEL.: 631-343-6000 FAX: 631-343-6008 E-MAIL: GCDC @ AOL.COM	REVISIONS NO. DATE REMARKS			REVISIONS NO. DATE REMARKS			THIS IS AN AS-BUILT OF SUITE 115 AS THE PROPERTY OF MELVILLE INDUSTRIAL ASSOCIATES HAS BEEN PROVIDED. CONTRACTOR SHALL VERIFY ALL FIELD CONDITIONS AND REPORT ANY DISCREPANCIES TO THE ARCHITECT IMMEDIATELY. ALL DIMENSIONS SHALL BE AS SHOWN ON THE DRAWING UNLESS OTHERWISE NOTED. ALL DIMENSIONS SHALL BE IN FEET AND INCHES. ALL DIMENSIONS SHALL BE TO THE CENTERLINE UNLESS OTHERWISE NOTED.	EXISTING SUITE LOCATED: SUITE 115 425 BROADMELLOW ROAD MELVILLE, NEW YORK 11747 FOR: MELVILLE INDUSTRIAL ASSOCIATES 445 BROADMELLOW ROAD MELVILLE, NEW YORK 11747	DATE: 11-21-10 SCALE: AS NOTED DRAWN: B.J.A. JOB NO: 1043-15	FIRST FLOOR SUITE LOCATION PLAN, SUITE 115 FLOOR PLAN DRAWING NO. SK-1.0